


**LEGEND:**

- STAGE 3A BOUNDARY
- CONSTRUCTION BOUNDARY
- PROPOSED MANHOLE
- EXISTING MANHOLE
- ⊕ PROPOSED FIRE HYDRANT
- EXISTING FIRE HYDRANT
- ⊗ PROPOSED VALVE
- ⊗ EXISTING VALVE
- ⊗ PROPOSED MAILBOX LOCATION
- ⊗ EXISTING MAILBOX LOCATION
- ⊗ PROPOSED CATCH BASIN
- ⊗ EXISTING CATCH BASIN
- △ PROPOSED PEDESTAL
- ⊗ PROPOSED TRANSFORMER
- ⊗ PROPOSED SWITCHING CUBICLE
- ⊗ PROPOSED STREETLIGHT
- ★ EXISTING STREETLIGHT
- ⚡ EXISTING POWERPOLE
- PROPOSED DRIVEWAY LOCATION
- PROPOSED CURBSTOP
- PROPOSED CULVERT
- EXISTING CULVERT
- ▲ PROPOSED STREET SIGN
- ▲ EXISTING STREET SIGN
- /b PROPOSED STREET BLADE

**NOTE:**

1. SCALE SHOP DRAWING OR FULL SIZE MOCK-UP TO BE SUBMITTED FOR APPROVAL.
2. BLADES OVER 1.2m TO HAVE AN UPGRADED ANCHOR OR WORDING/LETTERING TO BE ADJUSTED TO REDUCE LENGTH.
3. SIGNS TO BE NON-BREAKWAY; NO FOOTING REQUIRED INSTALLED TO DEPTH OF 1.2m WITH 150mm TAB.
4. ALL SIGN POST TO BE GALVANIZED METAL (SCHEDULE 40) 60mm IN DIAMETER.
5. ALL PAVEMENT MARKINGS TO BE INLAY THERMOPLASTIC AT FAC, PAINTED AT CCC.
6. ROAD NAMES TO BE RECONFIRMED PRIOR TO ORDERING.
7. ROAD BLADES TO BE GREEN WITH WHITE LETTERS AS PER CITY OF FORT SASKATCHEWAN STANDARDS.

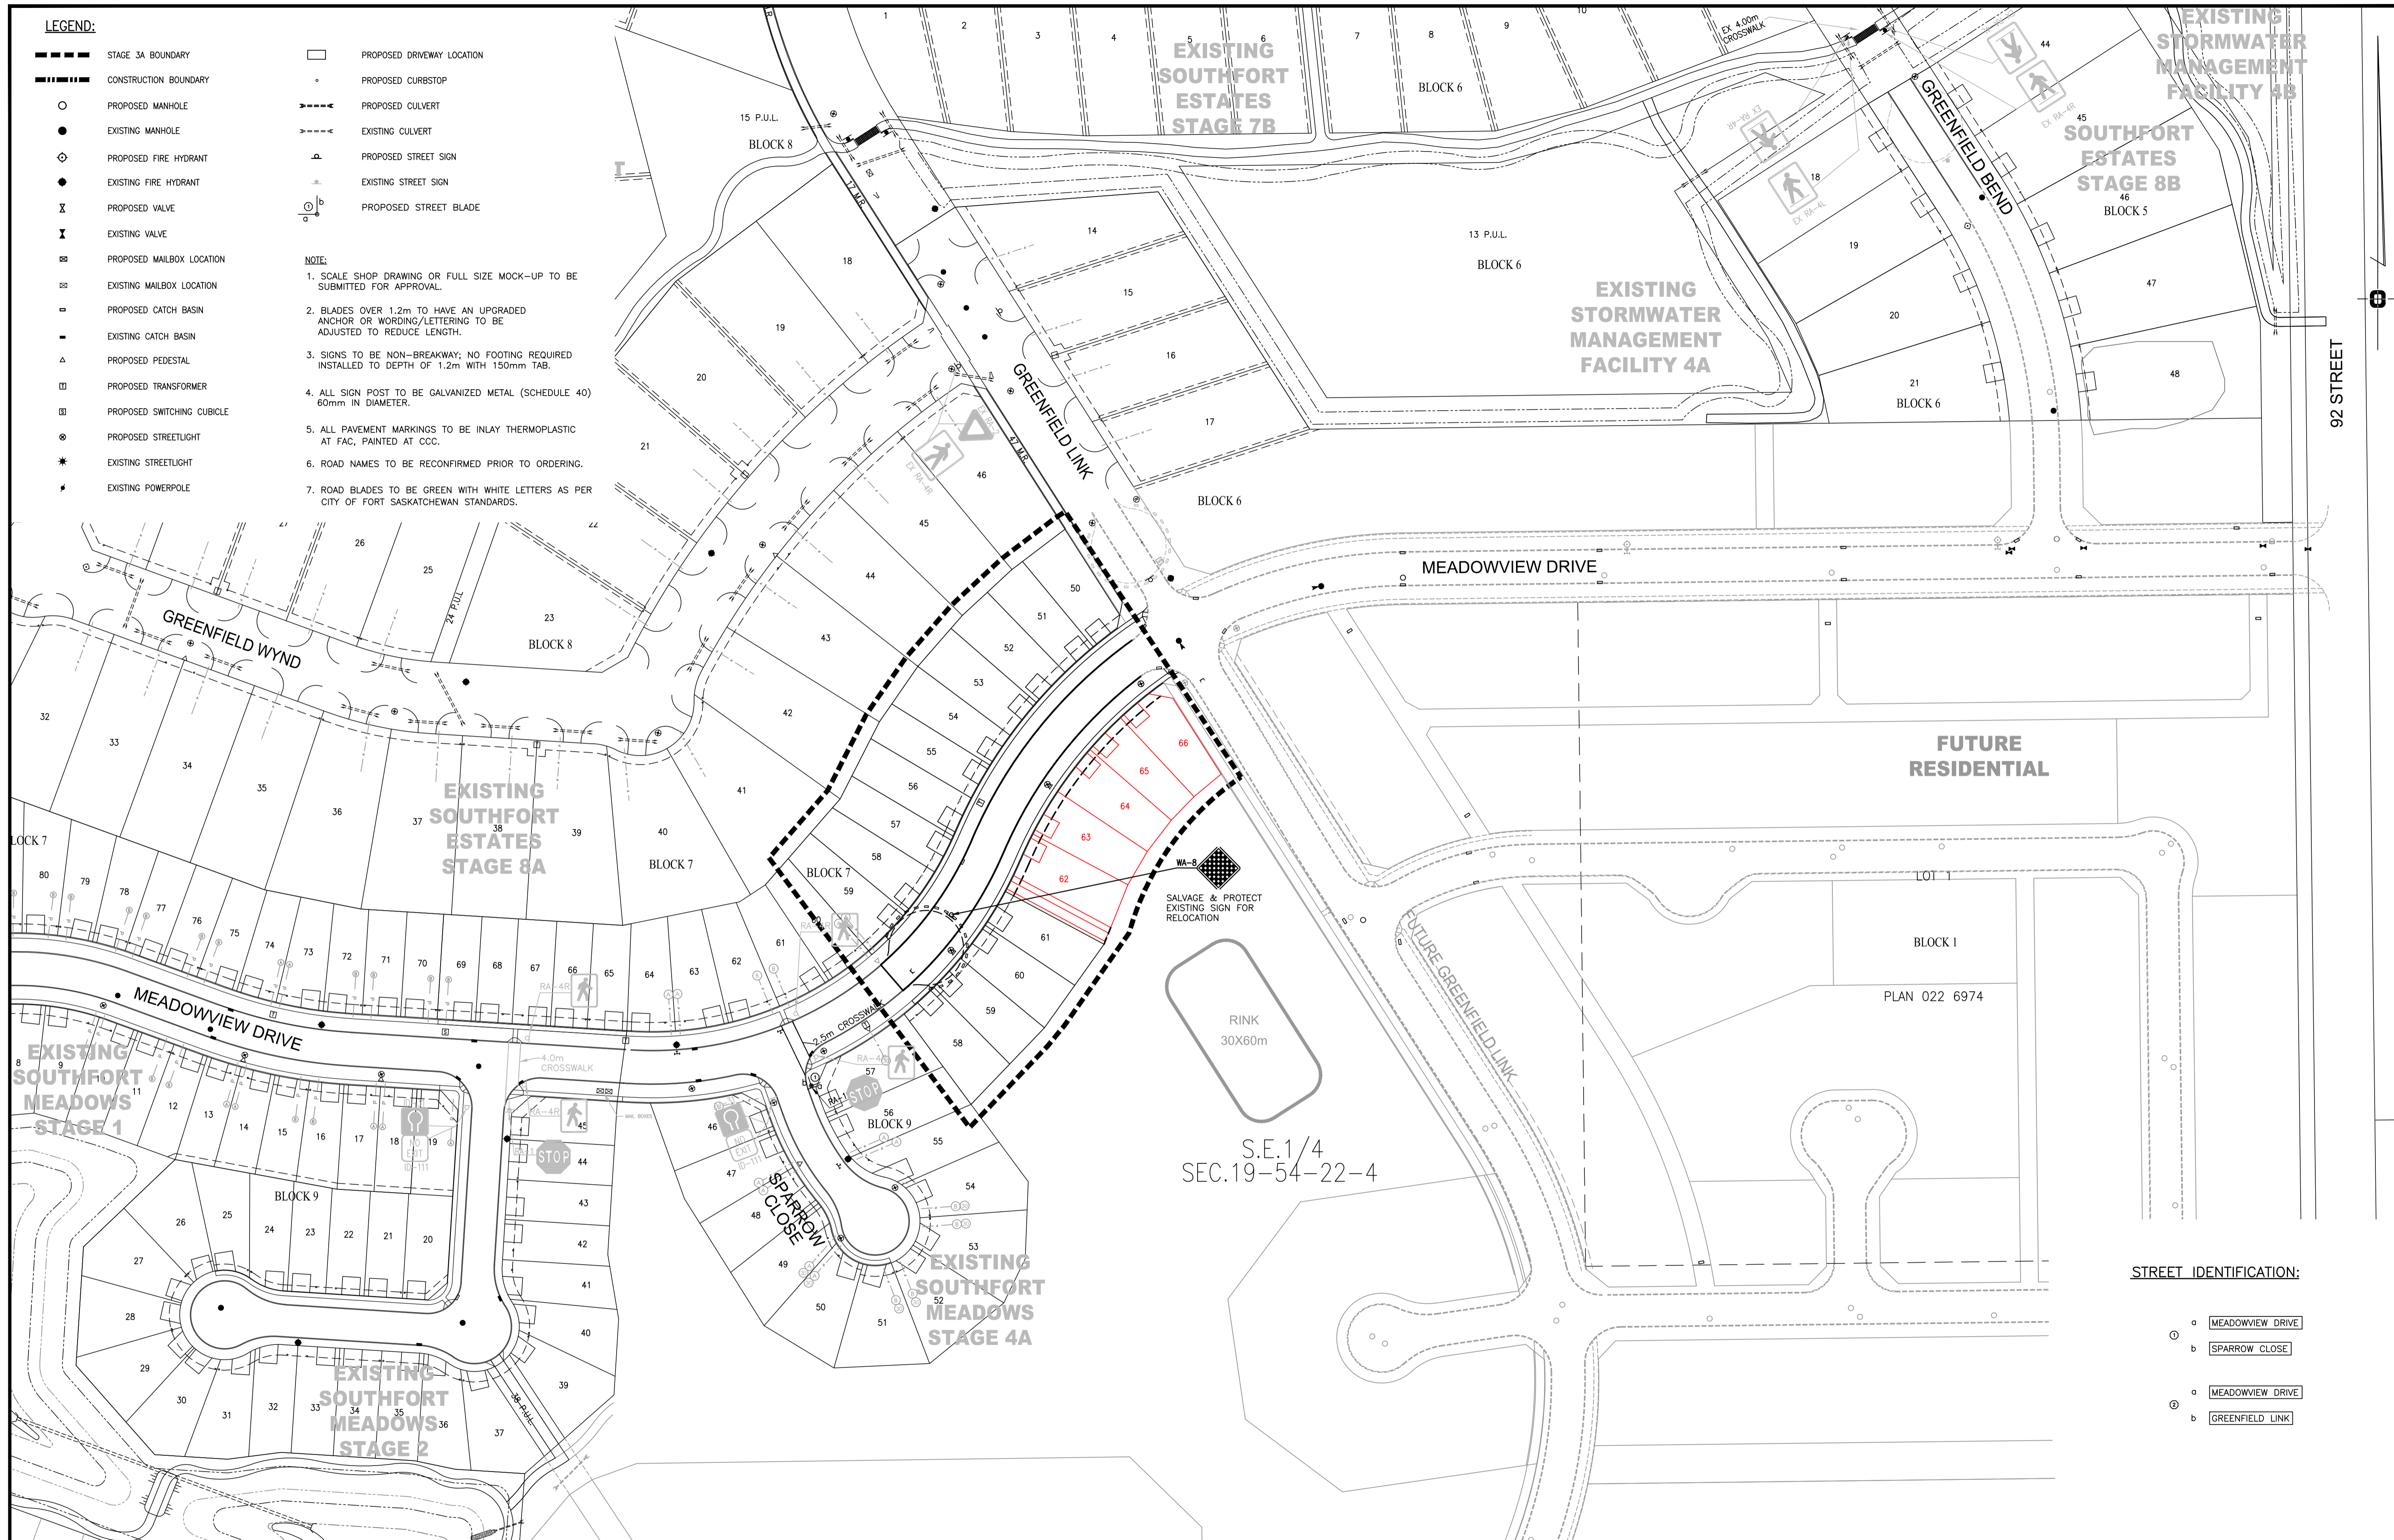

SALVAGE & PROTECT EXISTING SIGN FOR RELOCATION

S.E. 1/4  
SEC. 19-54-22-4

RINK  
30X60m


**STREET IDENTIFICATION:**

- a MEADOWVIEW DRIVE
- b SPARROW CLOSE
- a MEADOWVIEW DRIVE
- b GREENFIELD LINK

REVISION NO.	DESCRIPTION	BY	APP'D.	YY.MM.DD.
A	ISSUED FOR APPROVAL	B.C.	L.K.	2018.02.12
B	ISSUED FOR CONSTRUCTION	T.E.	B.J.P.	2018.04.23
C	ADDITIONAL LOTS REDLINE	D.K.	M.M.	2018.07.17



**PERMIT TO PRACTICE**  
WSP CANADA INC.  
Signature ORIGINALLY SIGNED ON:  
Date APRIL 25, 2018  
**PERMIT NUMBER: P07641**  
The Association of Professional Engineers and Geoscientists of Alberta

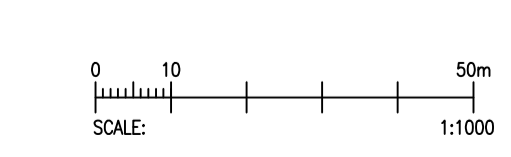

Client  
**SOUTHFORT DEVELOPMENT CORP.**

Project  
**SOUTHFORT MEADOWS STAGE 4B**  
FORT SASKATCHEWAN, ALBERTA  
**STREET FURNITURE PLAN**

Designed	Scale	Date
P.D.N.	1:1000	JUNE, 2018
Drawn	Project No.	
P.D.N.	060200994-121	
Checked	Drawing No.	Rev.
BJP	C04	D
Approved		
LK		